



M/W W.C.	W W.C.
±0 (SL+320) CH=3000	FL±0 (SL+320) CH=3000
タイル貼	タイル貼

ピロティ(3)
FL-20 (SL=GL=0)→水勾配 CH=4500
既存利用

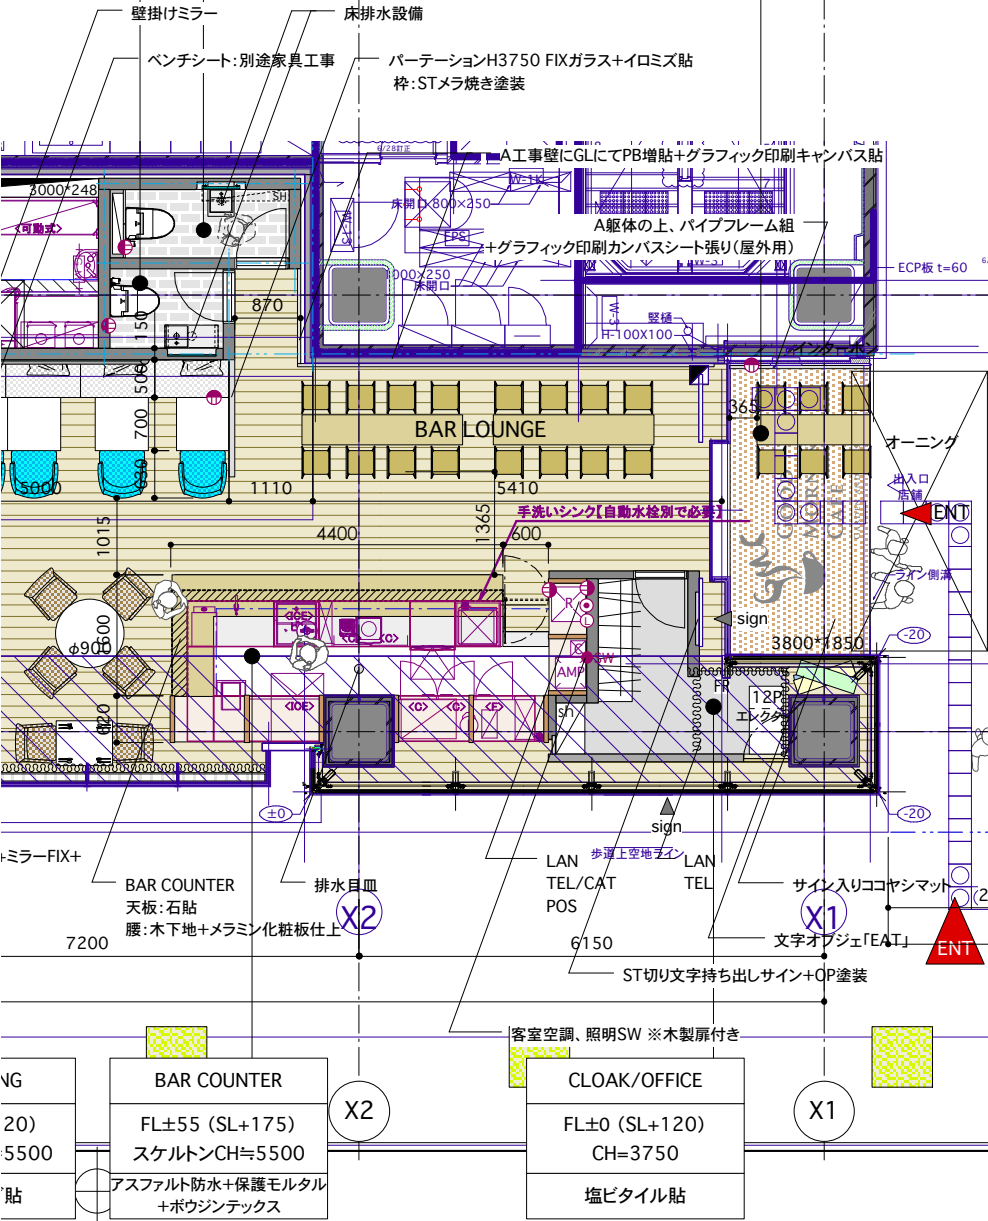


TERRACE LAYOUT	
STAGE TABLE : 16seats	70seats
TABLE : 34seats	
BAR ZONE : 22seats	

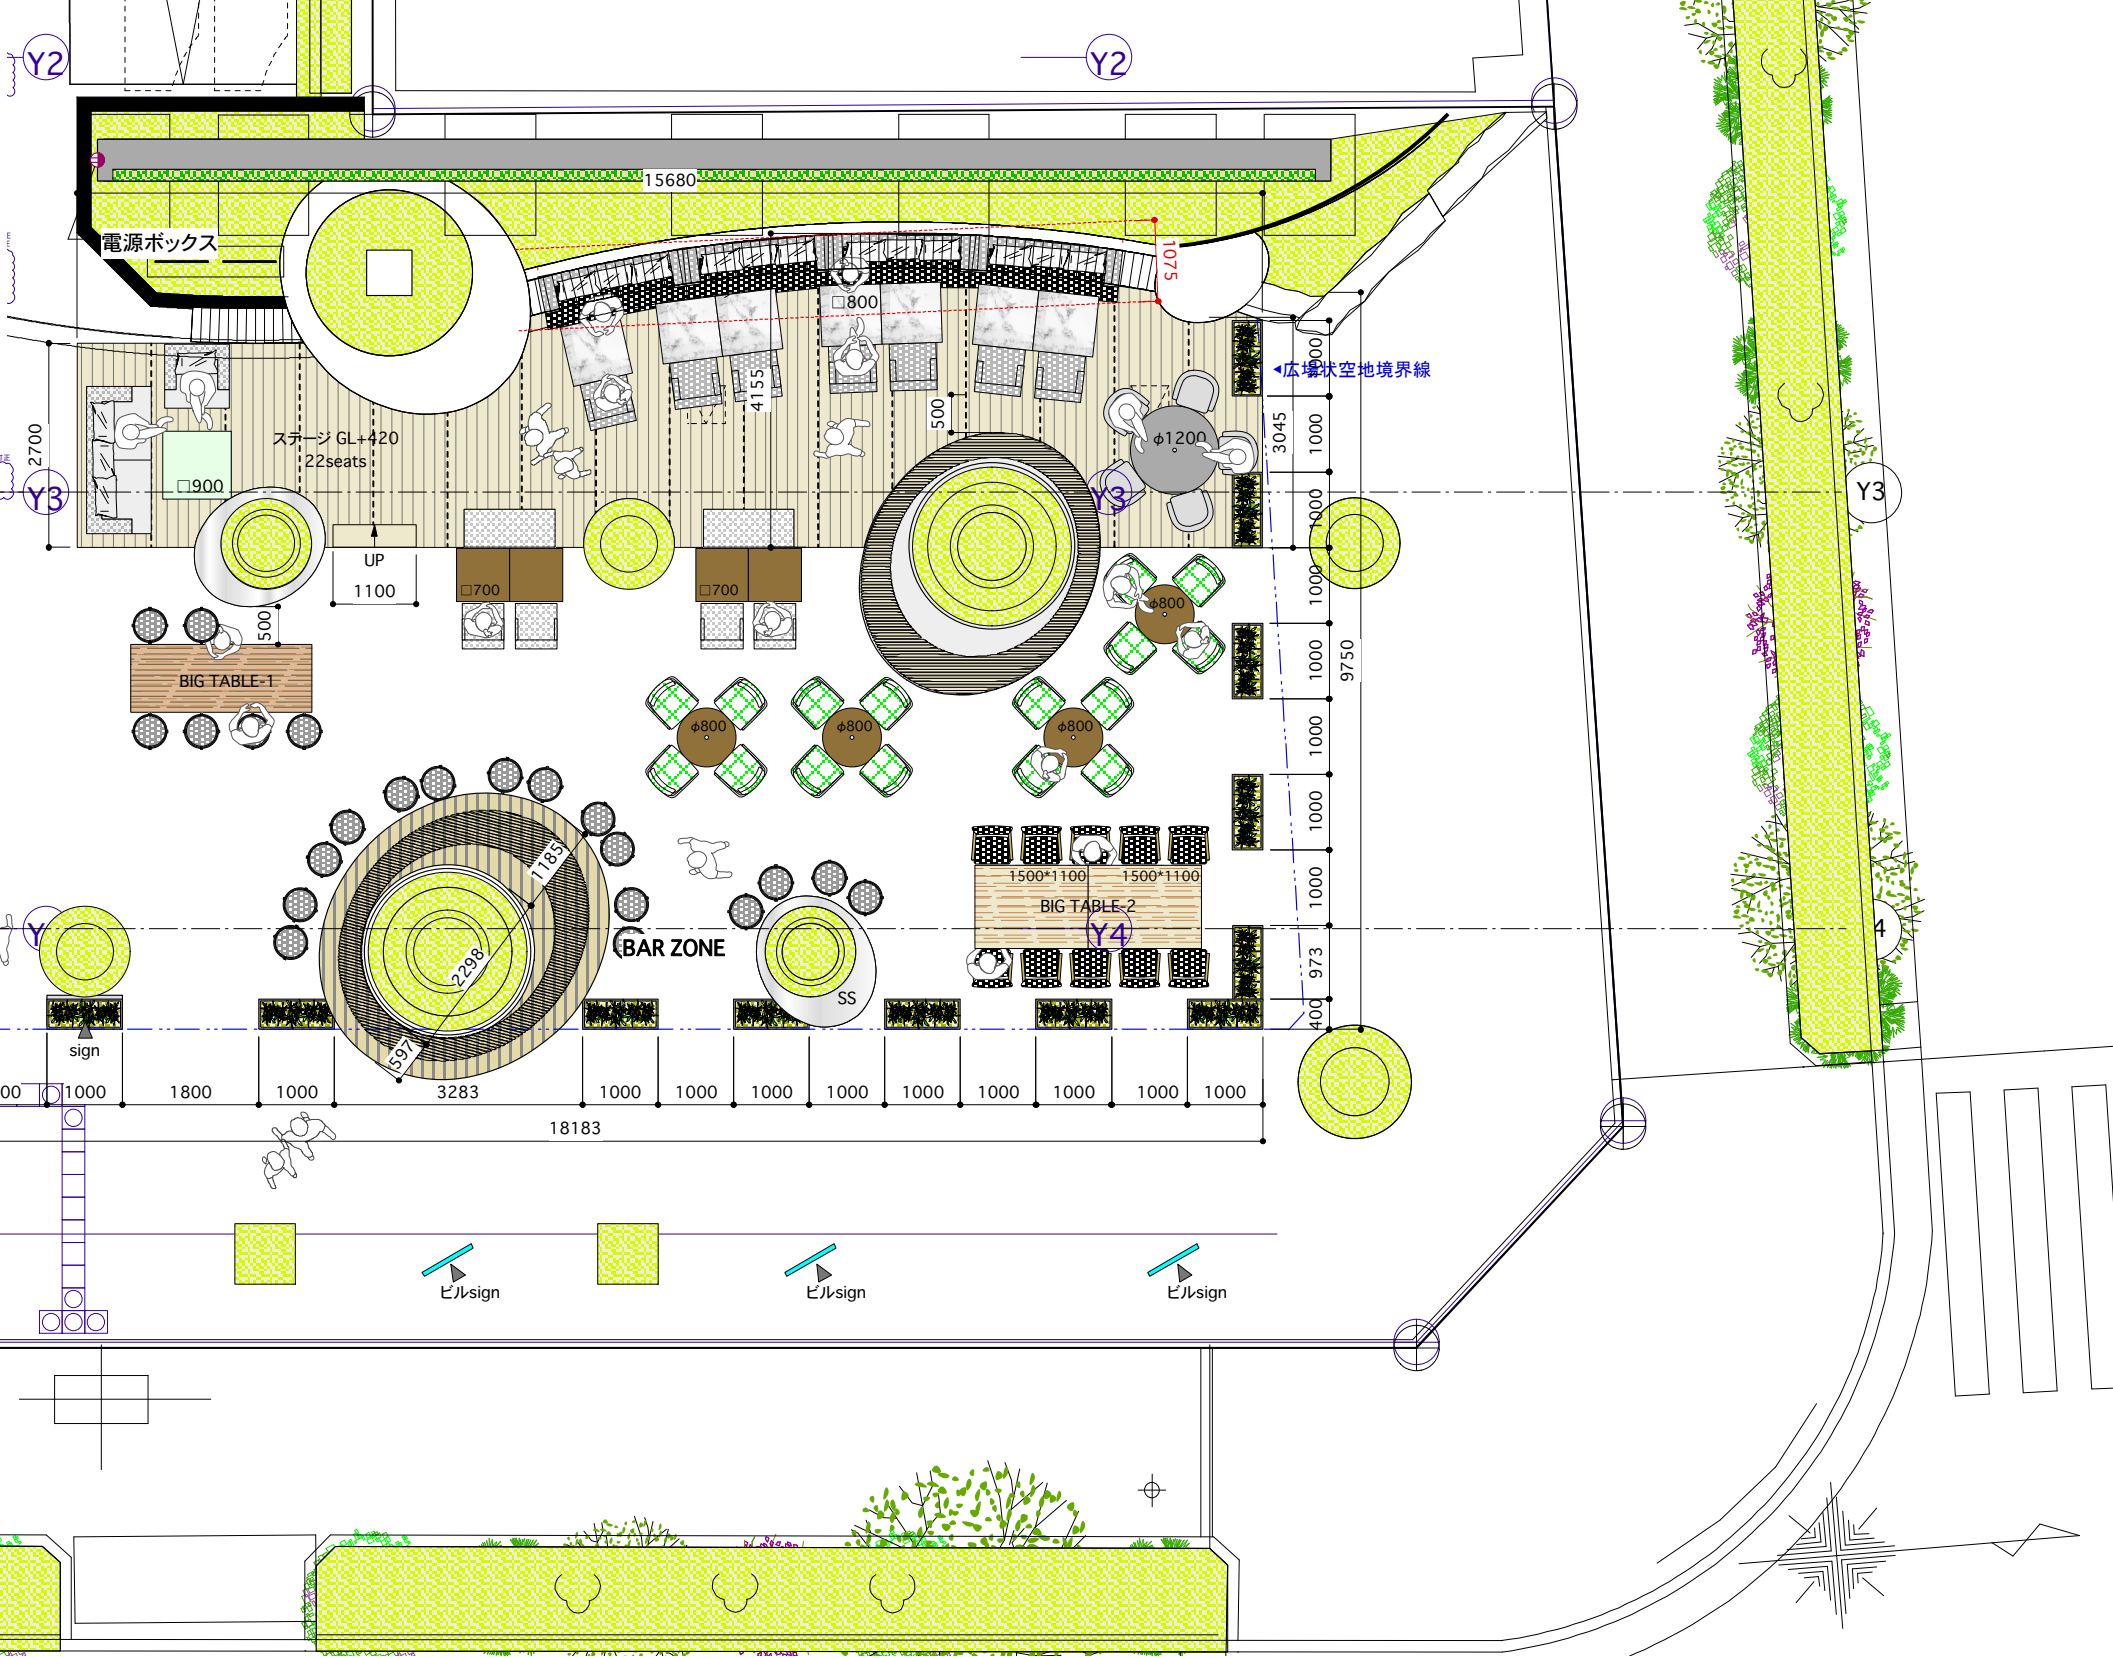

DINING LAYOUT	
68seats	TABLE : 54seats BAR : 16seats

DINING	137.2 sqm
PANTRY	5.3 sqm
KITCHEN	45.7 sqm
OFFICE	6.1 sqm
TOTAL	194.3 sqm

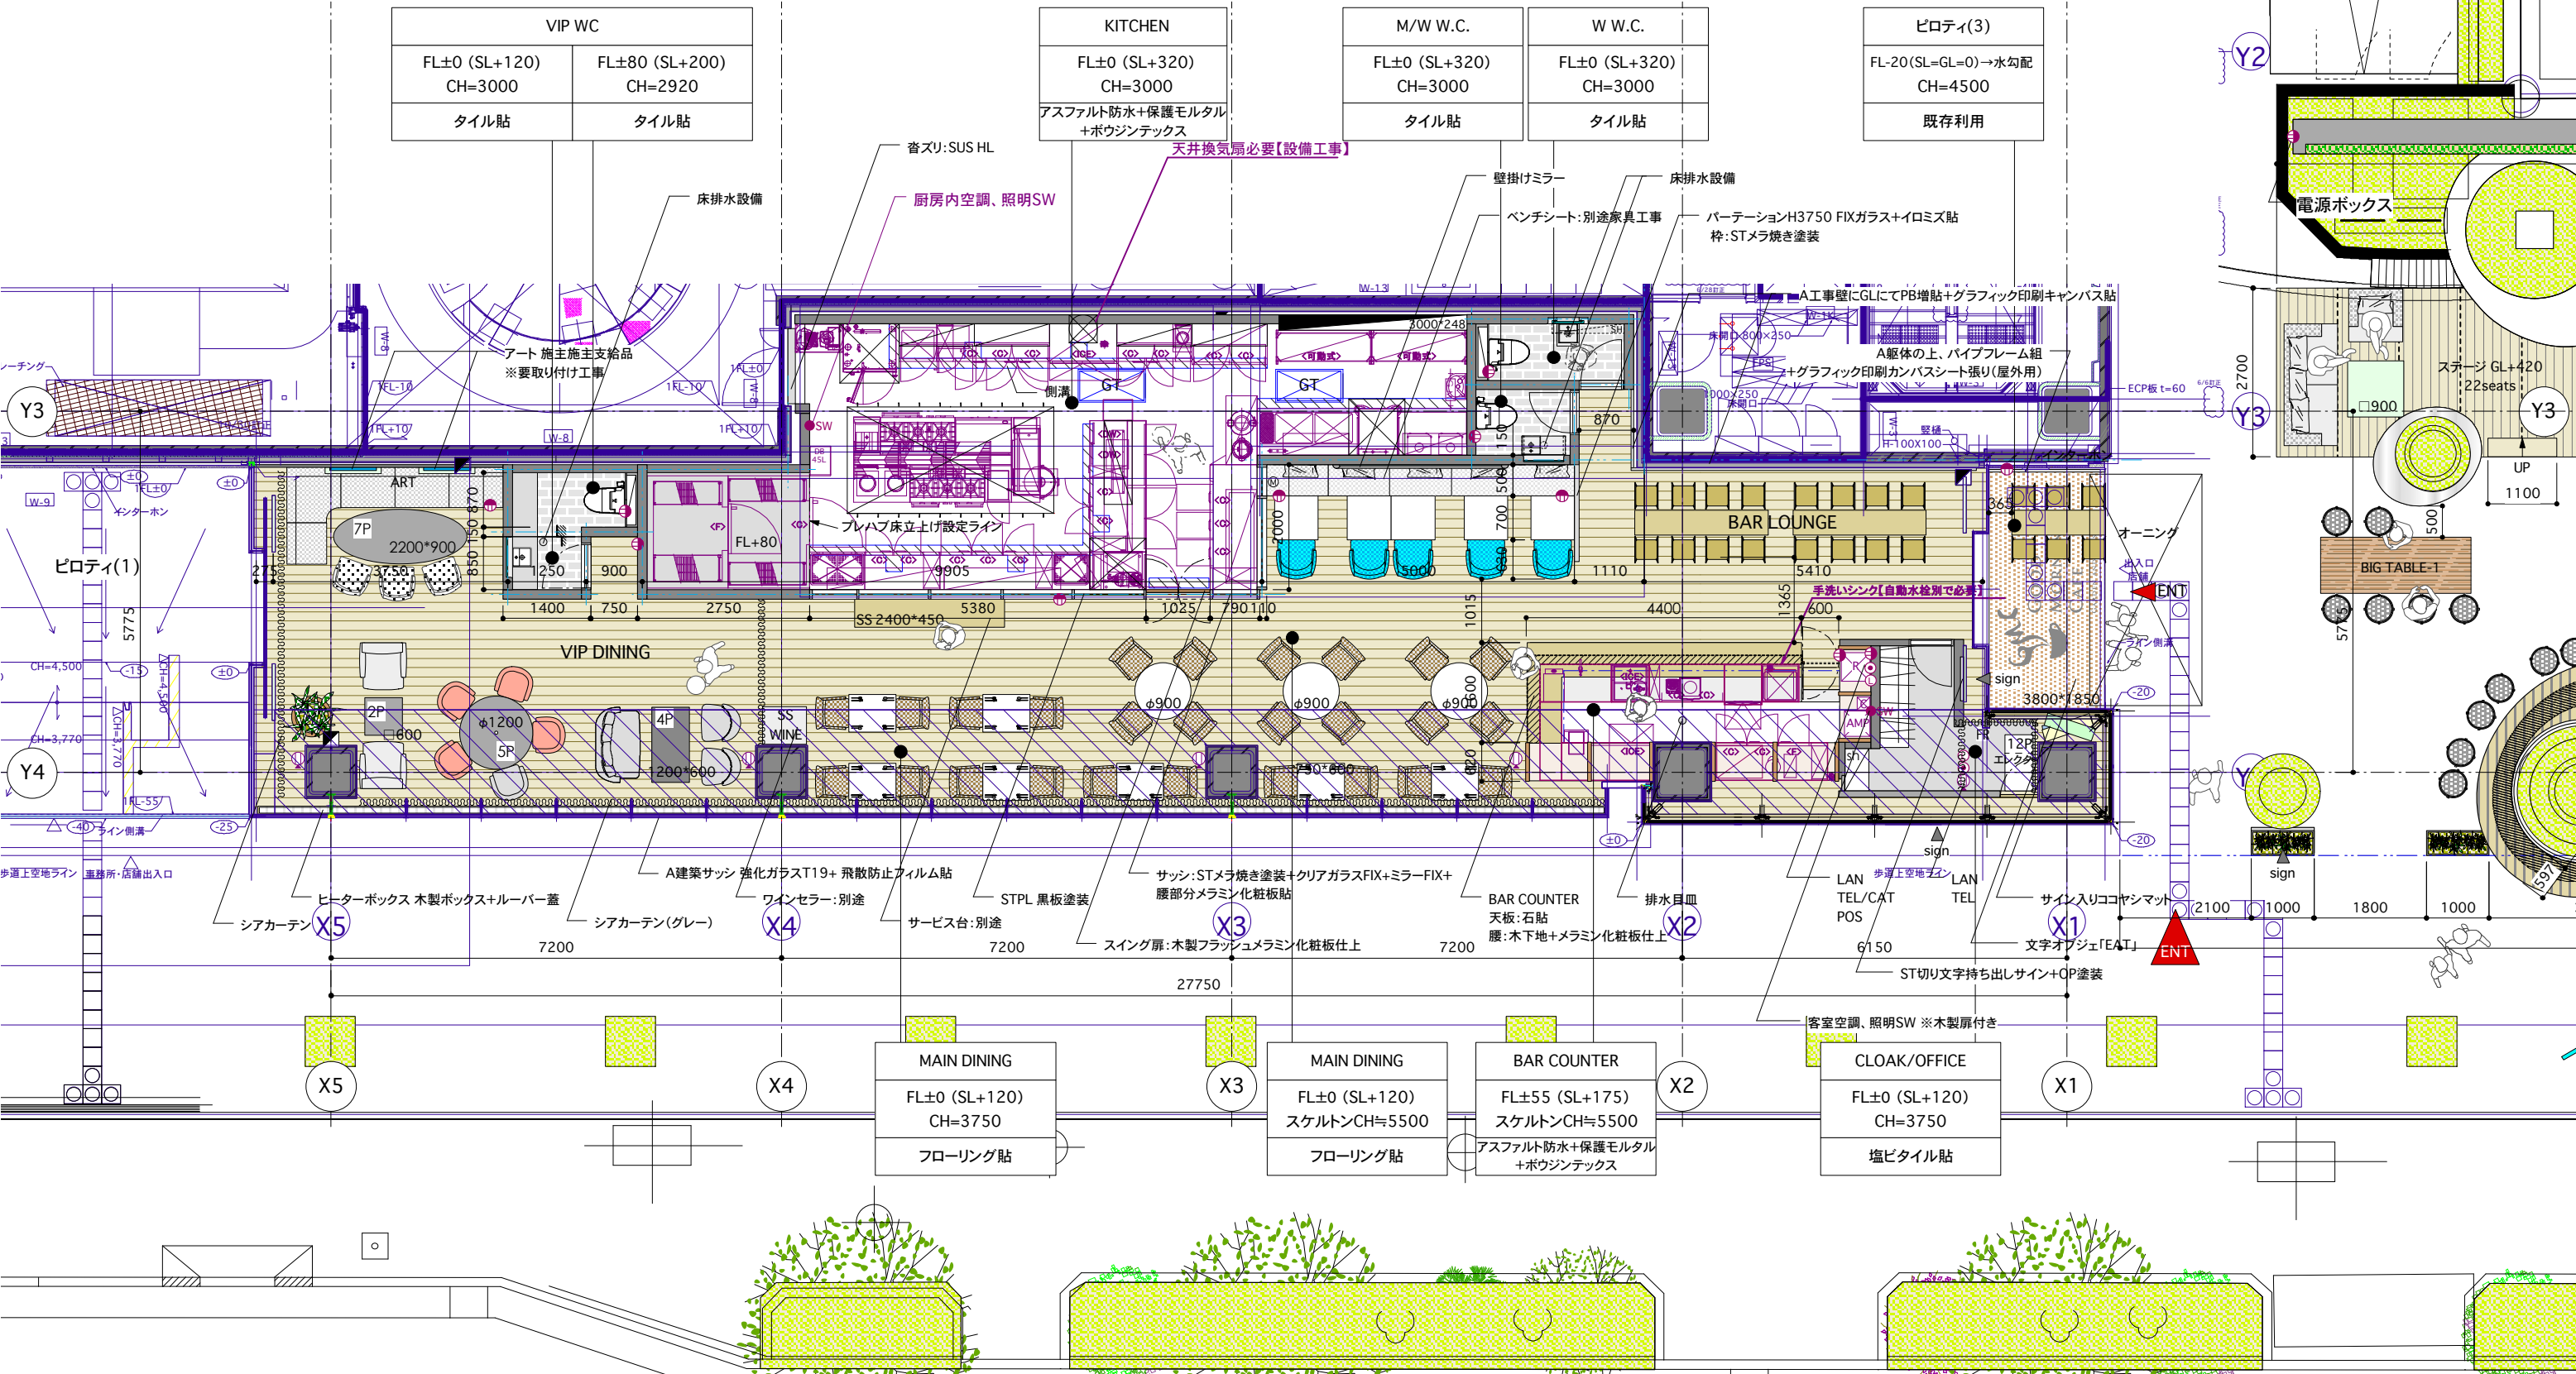

brownbag lab.

kyomachibori center bldg. #705, 1-17-16
Kyomachibori, nishi-ku, OSAKA

design

ABE

check

ABE

drawing

KURITA

project

仮称)
Good Morning Cafe
錦町トラッドスクエア店

title

1F PLAN

scale

1/100

date

20.AUG.2013
19.SEP.2013
10.OCT.2013
17.OCT.2013
31.OCT.2013(入札説明会)
3.DEC.2013
23.DEC.2013
28.APR.2014【竣工図書】

page No.